


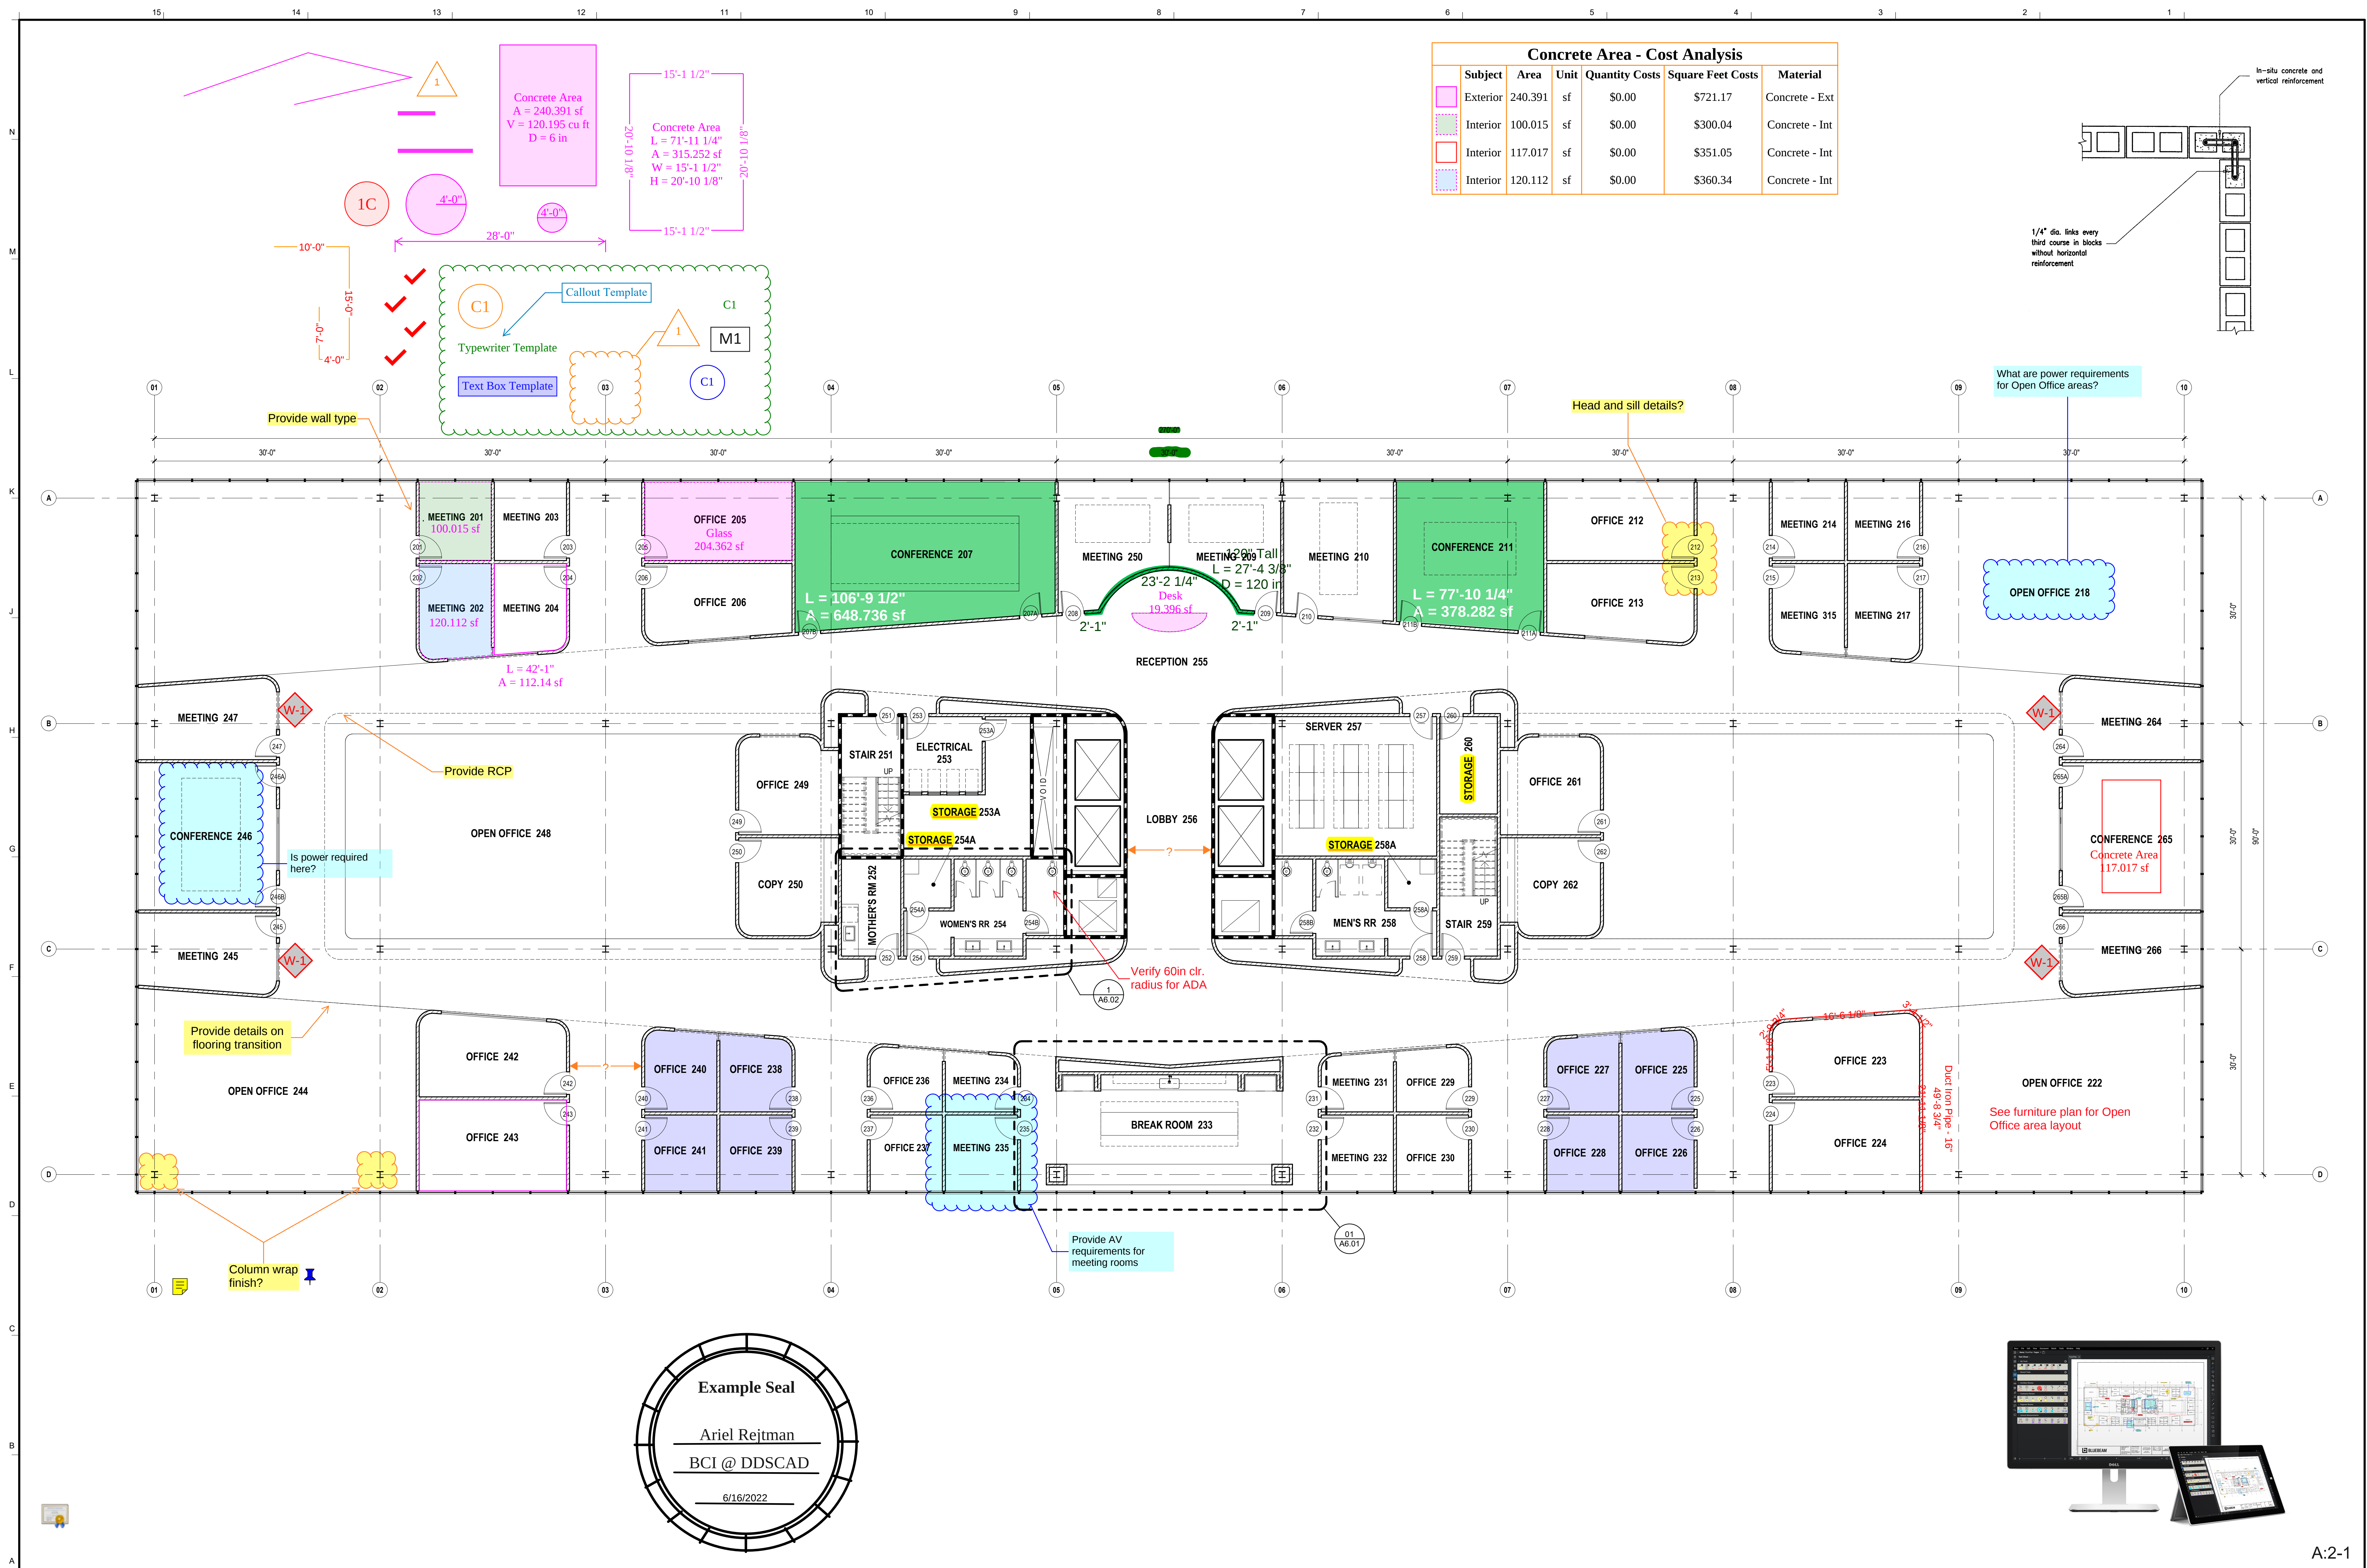

Concrete Area - Cost Analysis					
Subject	Area	Unit	Quantity	Costs	Square Feet Costs
Exterior	240.391	sf	\$0.00		\$721.17
Interior	100.015	sf	\$0.00		\$300.04
Interior	117.017	sf	\$0.00		\$351.05
Interior	120.112	sf	\$0.00		\$360.34

A:2-1



CAPTURE ENGINEERS
Mechanical
Electrical
Plumbing
1234 Miller St.
Manchester, NH 06930

REVU ARCHITECTS
5555 N. Broad St
Pasadena CA 91101

OFFICE BUILDING
Project No: 323232
Project Address:
123 Schonsett St
Chicago, IL 60601

THIS DRAWING IS INTENDED FOR
DEMONSTRATION PURPOSES
ONLY. DO NOT USE THIS
DRAWING FOR ANY OTHER
PURPOSE WITHOUT THE
EXPRESS WRITTEN PERMISSION
OF BLUEBEAM, INC.


DATE	03/04/2018	
ISSUED FOR:	INTERNAL REVIEW	
PROJECT	3232	
DRAWN BY:	Author	
CHECKED BY:	Checker	
APPROVED BY:	Approver	
#	DATE	DESCRIPTION

NOT FOR
CONSTRUCTION

STAMP:

STAMP:

SHEET TITLE & NUMBER
LEVEL 02 FLOOR
PLAN (Marks)
A2.2.1
© 2018 Bluebeam, Inc.

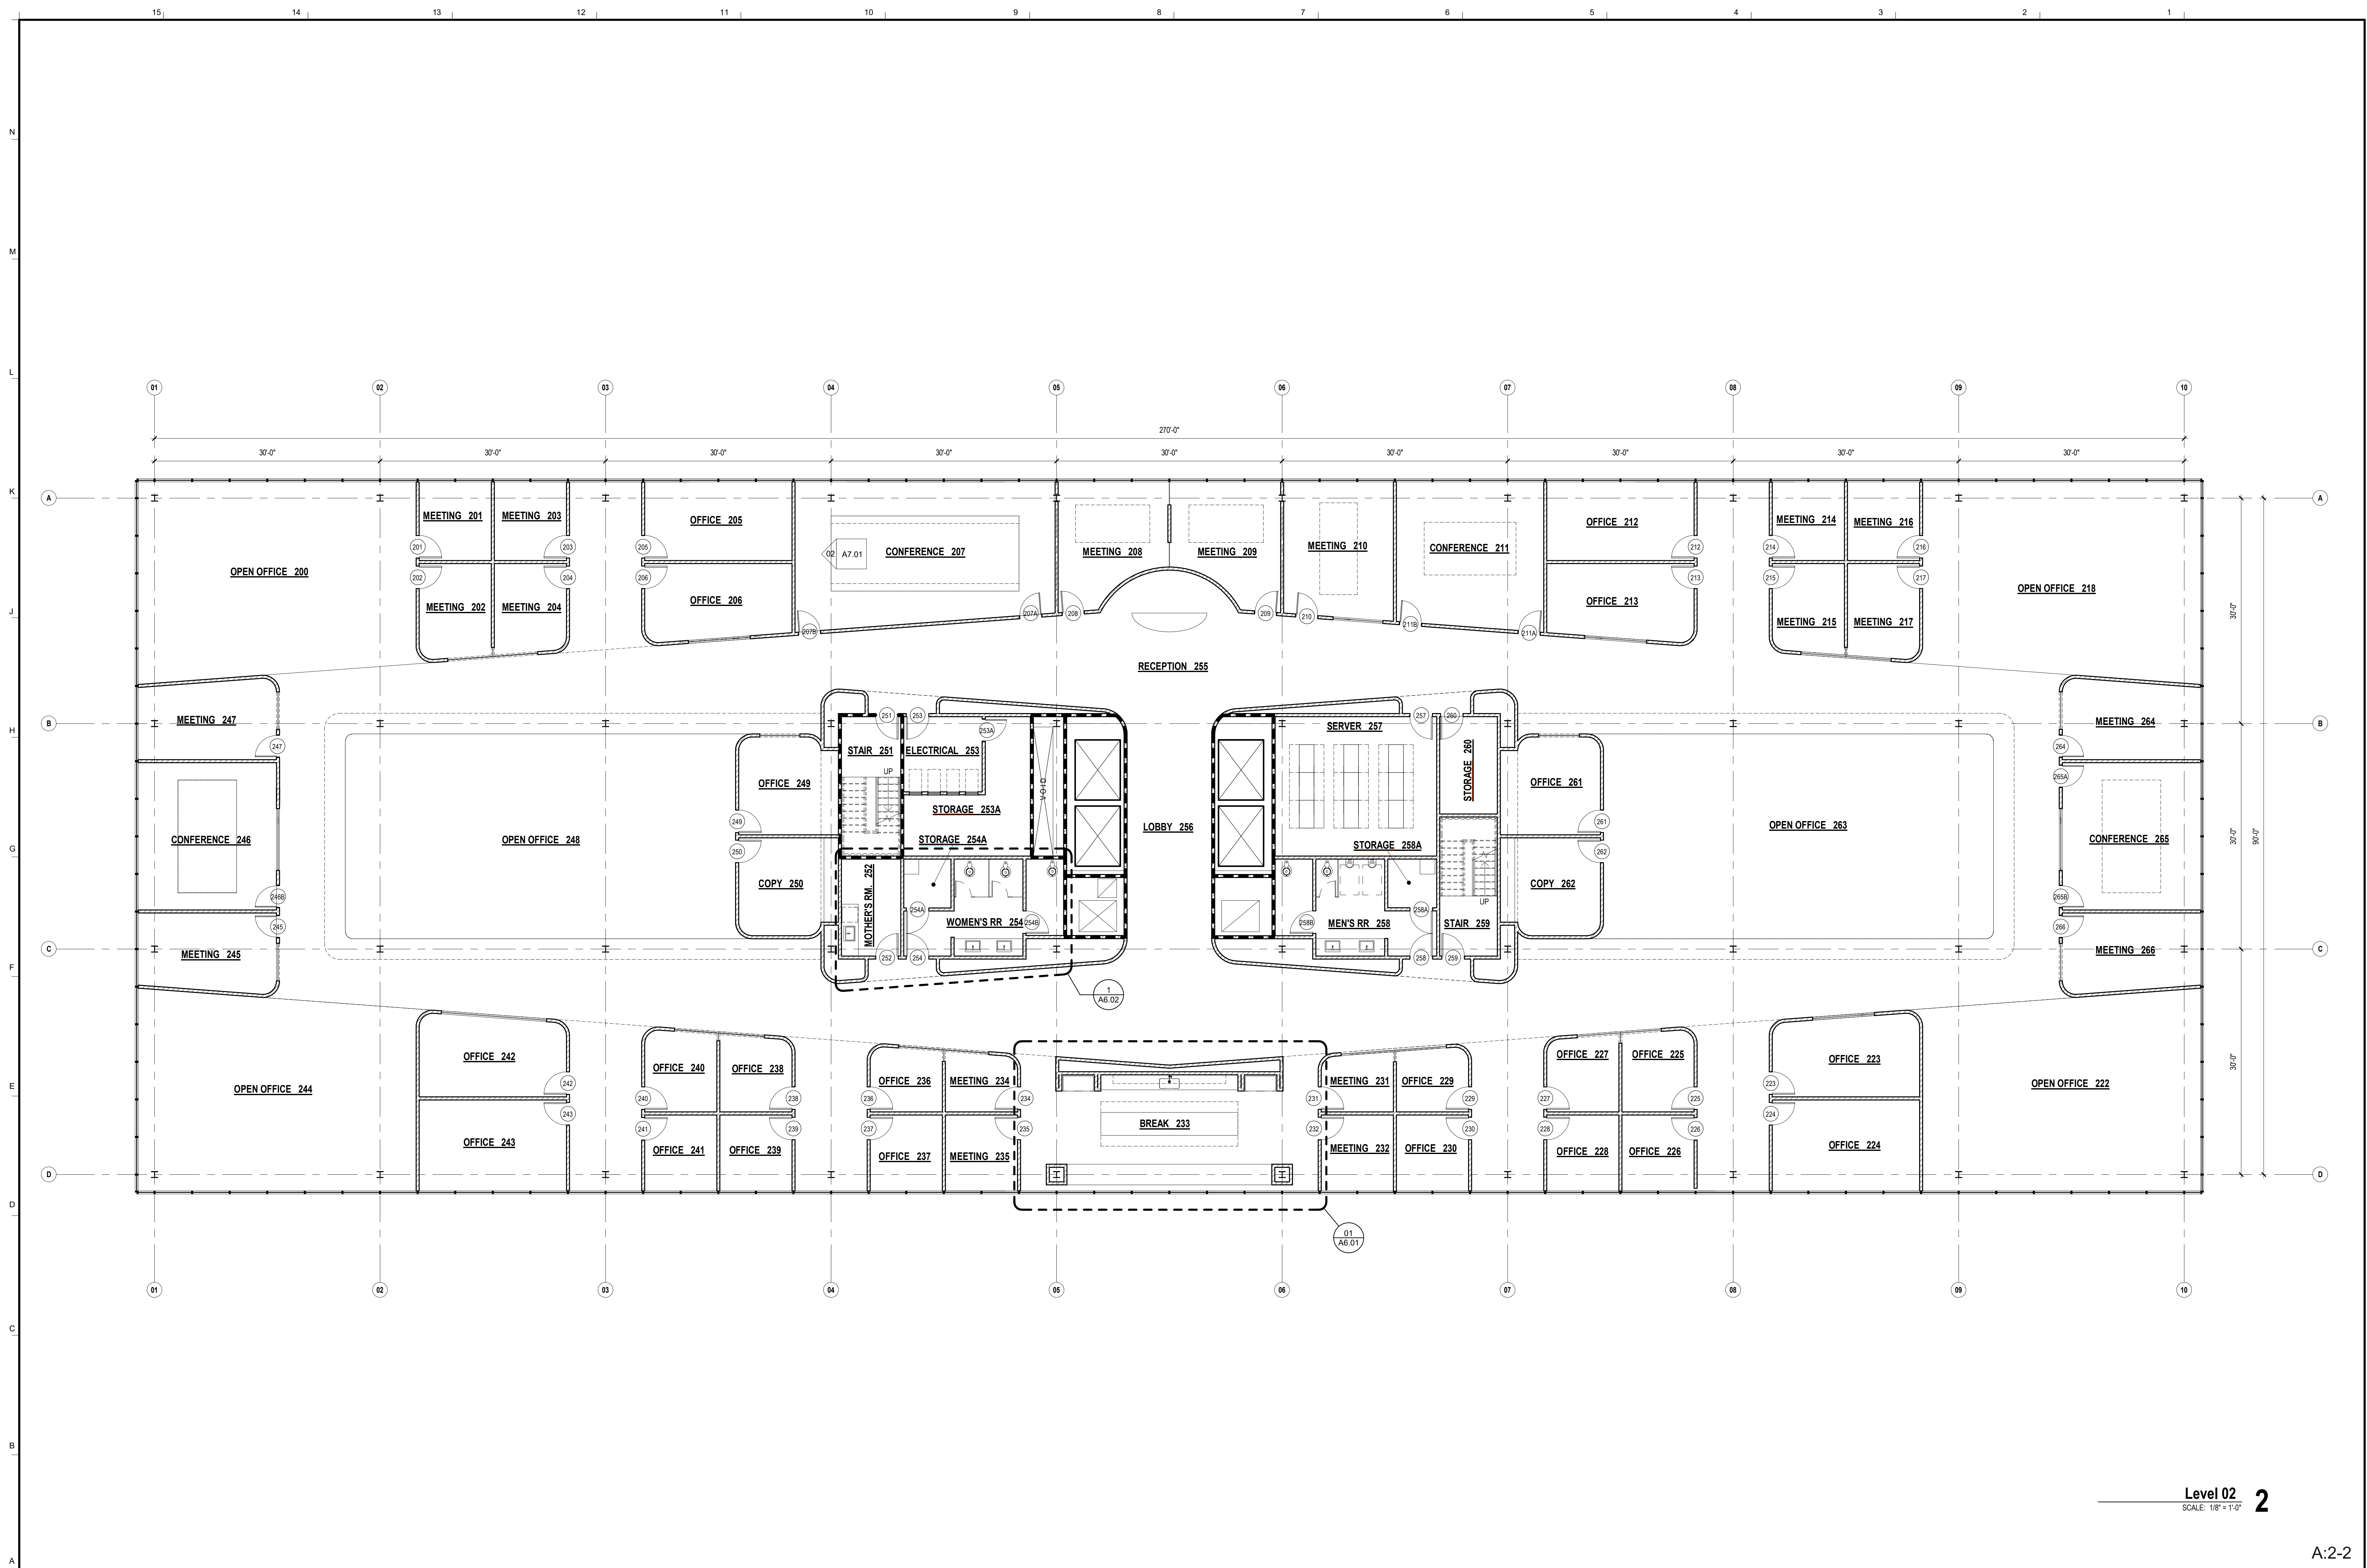

Level 02 2
SCALE: 1/8" = 1'-0"

A:2-2



Capture Engineers
Mechanical
Electrical
Plumbing

1234 Miller St.
Manchester, NH 06930

REVU ARCHITECTS

5555 N. Broad St
Pasadena CA 91101

OFFICE BUILDING

Project No: 323232

Project Address:
123 Schonsett St
Chicago, IL 60601

LEGAL DISCLAIMER:
ALL IDEAS, DESIGNS, AND PLANS INDICATED OR REPRESENTED BY THESE DRAWINGS ARE OWNED AND ARE THE PROPERTY OF BLUEBEAM, INC. AND WERE CREATED AND DEVELOPED FOR DEMONSTRATION PURPOSES ONLY. NONE OF SUCH IDEAS, DESIGNS, OR PLANS SHALL BE USED FOR ANY PURPOSE WHATSOEVER EXCEPT AS A DEMONSTRATION SET WITHOUT THE EXPRESSED WRITTEN CONSENT OF BLUEBEAM, INC.

DATE: 03/04/2018
ISSUED FOR: INTERNAL REVIEW
PROJECT: 3232
DRAWN BY: Author
CHECKED BY: Checker
APPROVED BY: Approver
DATE DESCRIPTION

**NOT FOR
CONSTRUCTION**


STAMP:

STAMP:

SHEET TITLE & NUMBER
LEVEL 02 FLOOR
PLAN (Old)

A2.2.2

Copyright Bluebeam Software

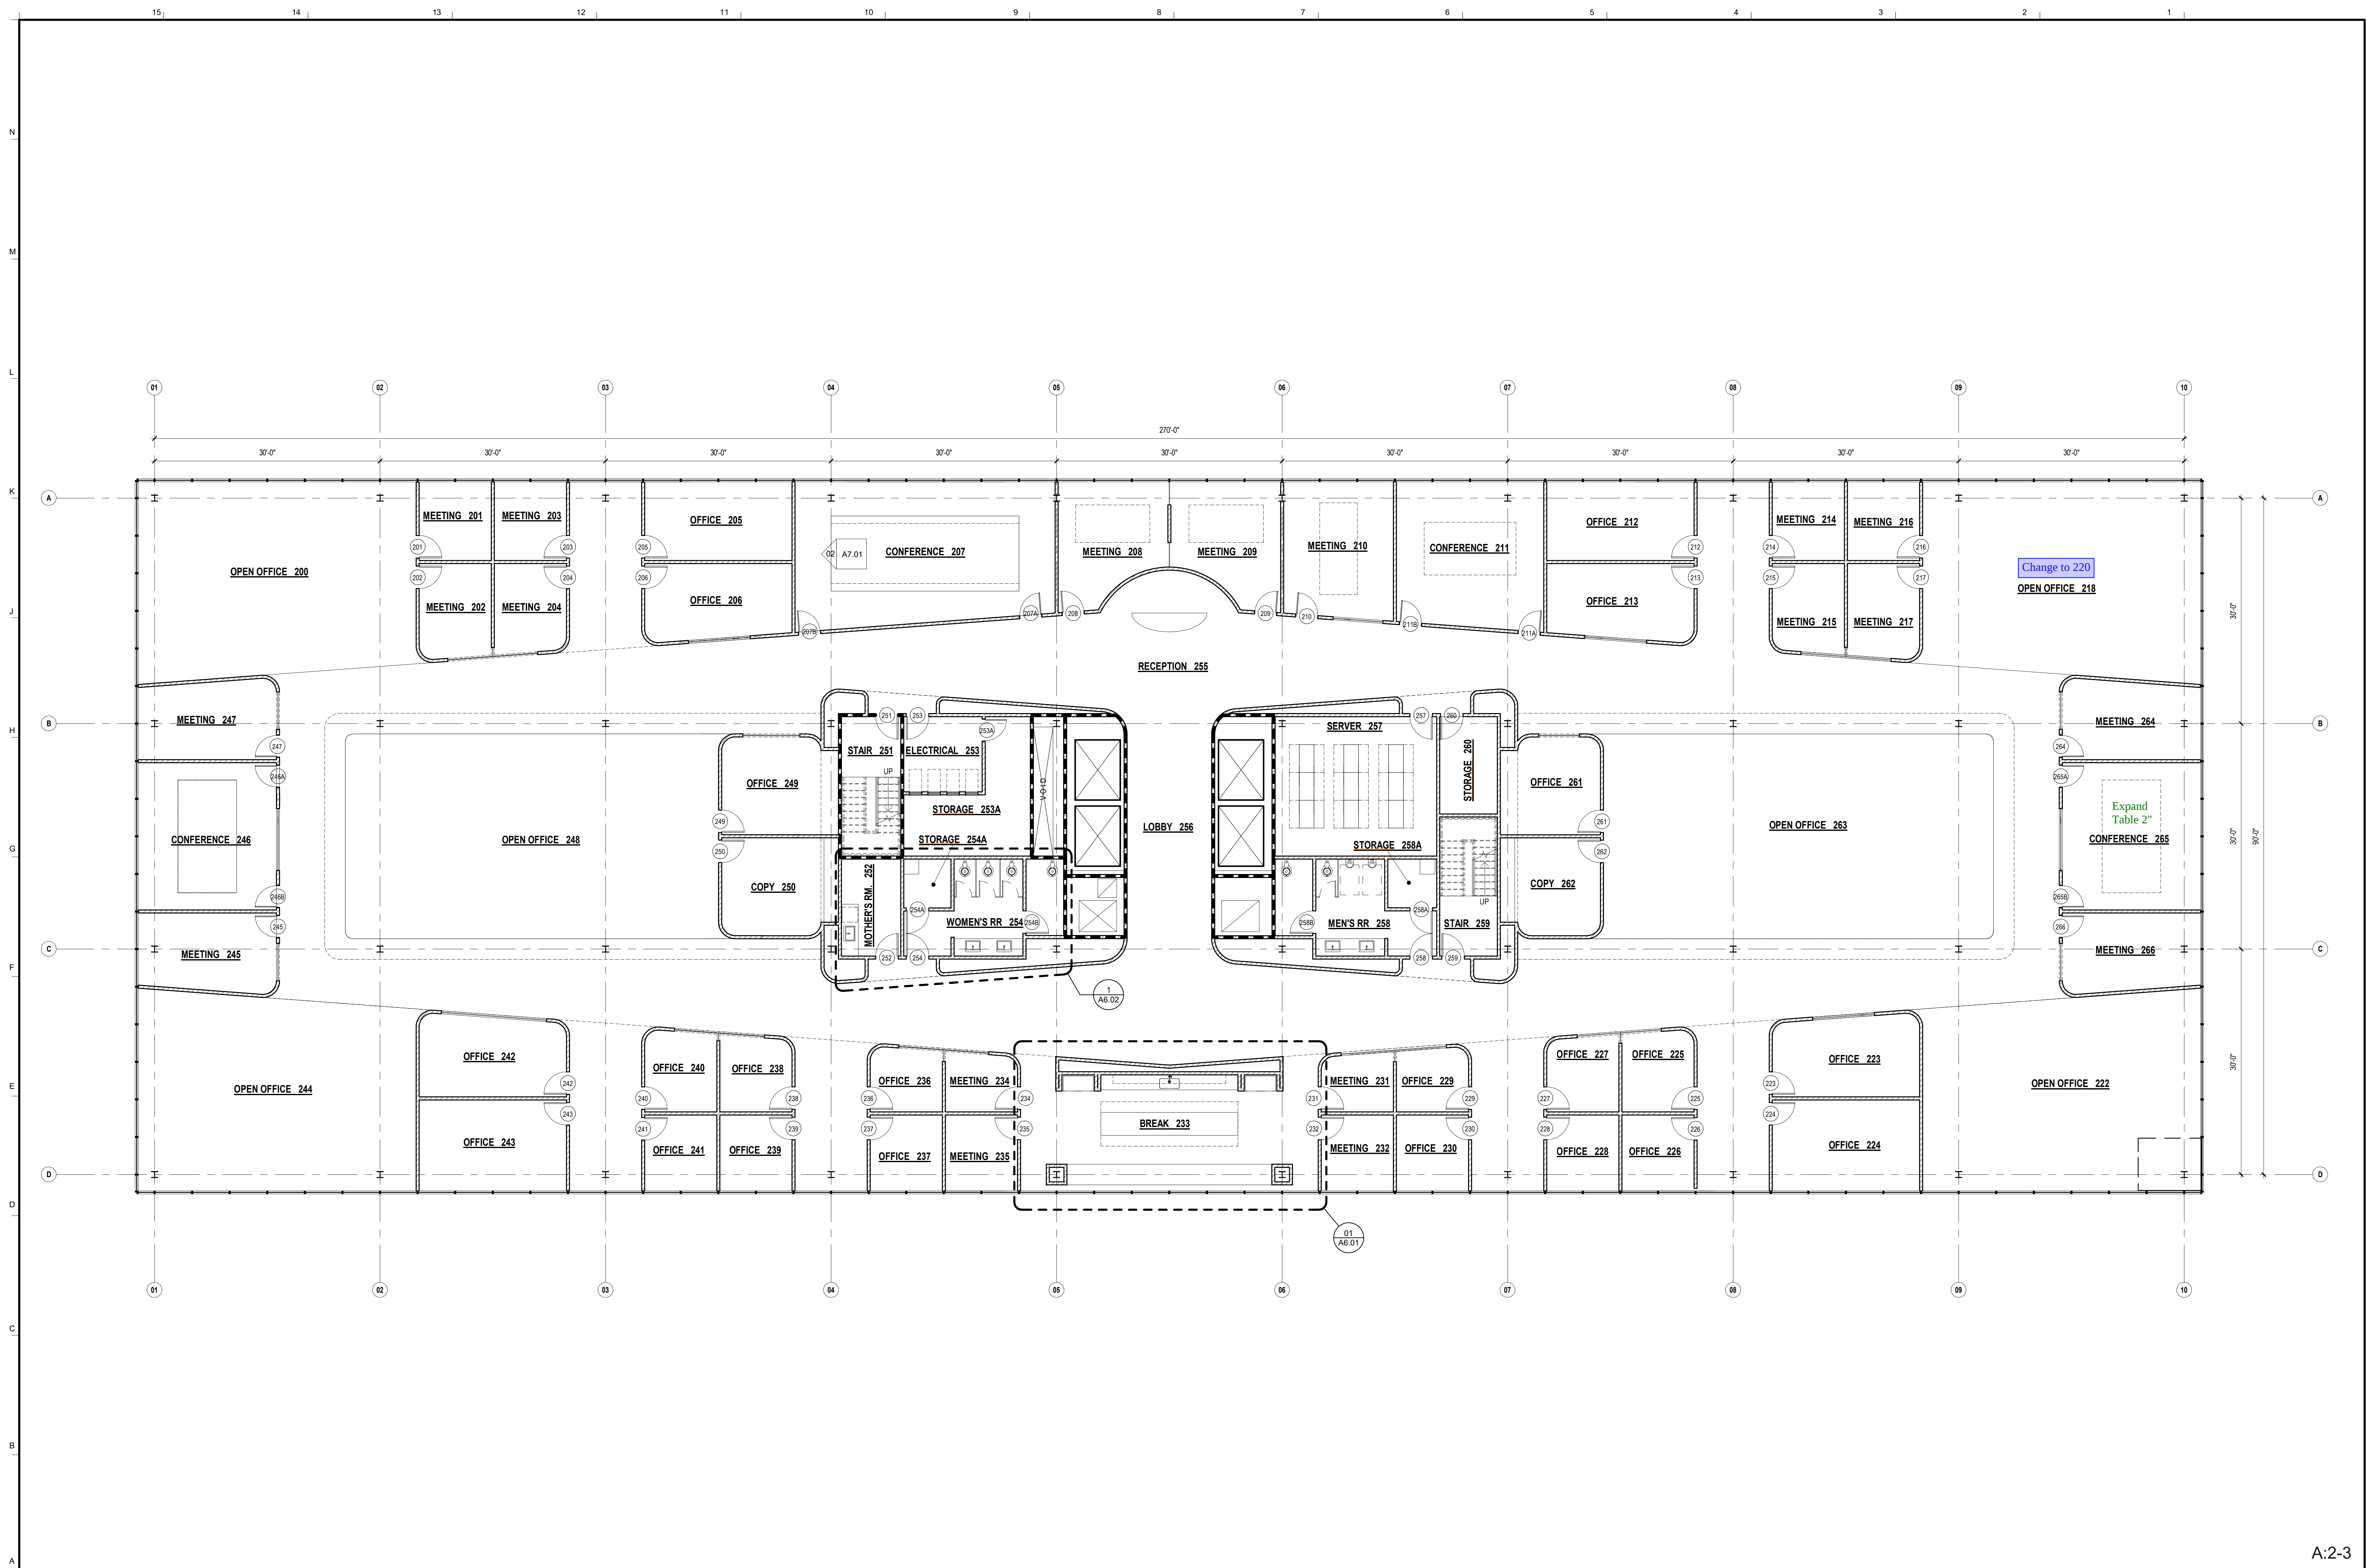

A:2-3



Capture Engineers
Mechanical
Electrical
Plumbing

1234 Miller St.
Manchester, NH 06930

REVU ARCHITECTS

5555 N. Broad St
Pasadena CA 91101

OFFICE BUILDING

Project No: 323232

Project Address:
123 Schonsett St
Chicago, IL 60601

LEGAL DISCLAIMER:

ALL IDEAS, DESIGNS, AND PLANS INDICATED OR REPRESENTED BY THESE DRAWINGS ARE OWNED AND ARE THE PROPERTY OF BLUEBEAM, INC. AND WERE CREATED AND DEVELOPED FOR DEMONSTRATION PURPOSES ONLY. NONE OF SUCH IDEAS, DESIGNS, OR PLANS SHALL BE USED FOR ANY PURPOSE WHATSOEVER EXCEPT AS A DEMONSTRATION SET WITHOUT THE EXPRESSED WRITTEN CONSENT OF BLUEBEAM, INC.

DATE 03/04/2018
ISSUED FOR: INTERNAL REVIEW

PROJECT 3232
DRAWN BY: Author
CHECKED BY: Checker
APPROVED BY: Approver
DATE DESCRIPTION

**NOT FOR
CONSTRUCTION**

STAMP:

STAMP:

SHEET TITLE & NUMBER
LEVEL 02 FLOOR
PLAN (New)

A2.2.3

Copyright Bluebeam Software

Bluebeam Revu Essentials Course - Outline

This course will introduce you to many essential features of Revu. Students will become familiar with Revu's tools and will be prepared to use Revu to improve their workflow.

I. Interface & Navigation

- Custom Profiles & Optimal Settings
- The Status Bar
- File Access & Cloud Storage
- Synchronize Pages & Documents
- Rulers & Crosshairs
- Page Settings

II. Markups & Measurements

- Text, Lines, Cloud+, Images, etc.
- Subjects & Sorting
- Custom Markups, Exporting & Importing
- Drawing Mode & Properties Mode
- Measurements, Calibrations, Preset Scales, & Dynamic Fills

III. Signatures, Stamps, & Certifications

- Creating a Digital ID
- Certifying Documents
- Signatures
- Exporting .cer files
- Forms & Form Mode
- Stamps
- Viewing Unchanged Documents

IV. The Markups List & Summary Reports

- Custom Columns
- Sorting & Filtering
- Import & Export Mark-Ups
- Summary Reports & Hyperlinked Markups
- Cost Analysis

V. Bluebeam Studio

- Sessions & Projects
- Checking Files In & Out
- Revision History
- Markups in Sessions
- Replies & Alerts
- Session Reports

VI. Security, Flattening, & Misc

- Compare Documents
- Overlay Pages
- Flatten Individual Markups, Measurements, & Images.
- Markup Recovery & Unflatten Markups
- Visual & Text Search
- Document Security

Note: The suggested class duration is a guideline. Topics and duration may be modified by the instructor based upon the knowledge and skill level of class participants.

Bluebeam Certified Instructor

Ari Rejtman

has completed all the requirements to be a Bluebeam Certified Instructor of the course:

Revu 2018: Essentials

And is Awarded this Certificate By

Bluebeam Software, Inc.

August 1, 2019

Scott Koenig
Sr. Software Trainer



BLUEBEAM CERTIFIED PROFESSIONAL



Ari Rejtman

has successfully completed the
Bluebeam Certified Professional Exam

Jon Elliot

Chief Executive Officer, Bluebeam, Inc.
A Nemetschek Company

Issued on: 02 OCT 2023



Your CAD / BIM Business Partner



DIGITAL DRAFTING SYSTEMS

5765 NW 158 Street, Miami Lakes, FL 33014 Ph: (305) 445-6480 Fax: (305) 445-6526

CREDIT CARD CHARGE AUTHORIZATION

I authorize Digital Drafting Systems to charge the following credit card:

VISA

MASTER CARD

AMERICAN EXPRESS

DINNERS

Credit Card #: _____ Expiration Date: _____

Card Holder Name: _____ V-Code: _____

Amount: \$ _____ Signature: _____

Telephone: _____

Billing Address: _____

City: _____ State: _____ Zip Code: _____

Ship To:

☐ Same as above

☐ Different

Shipping Address: _____

City: _____ State: _____ Zip Code: _____

IMPORTANT: PLEASE INCLUDE A PHOTOCOPY OF BOTH SIDES OF YOUR ACTUAL CREDIT CARD